322D7938

THIRD ANGLE PROJECTION

DIMENSIONS IN INCHES UNLESS OTHERWISE STATED

DO NOT SCALE DRAWING

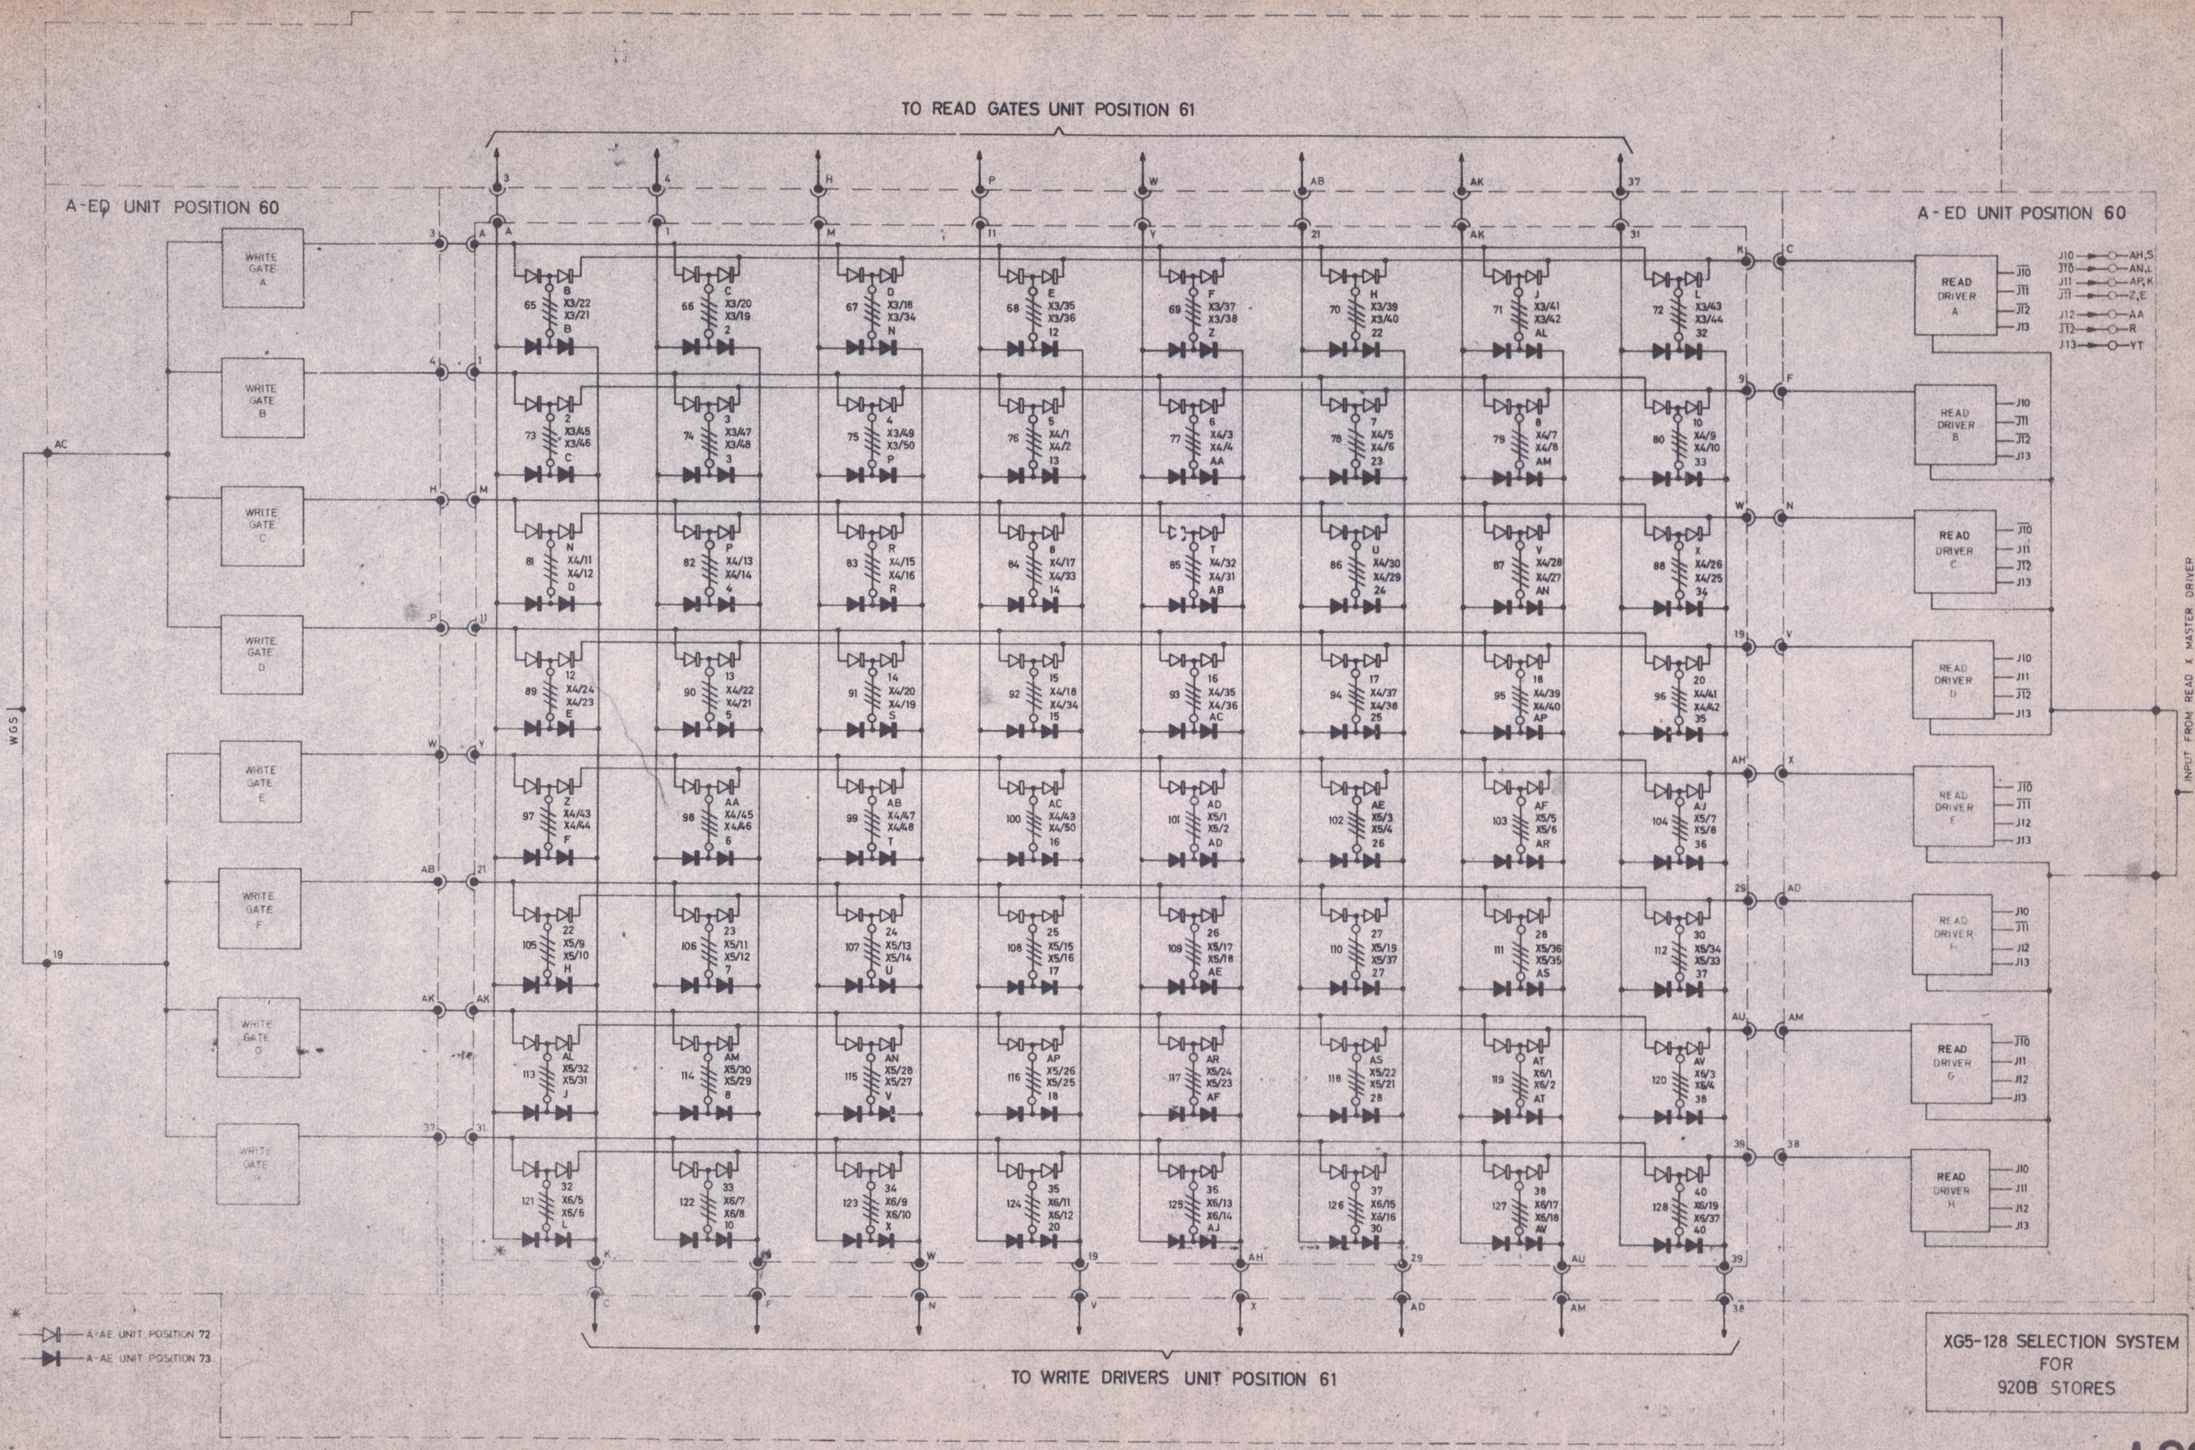

XG5-128 SELECTION SYSTEM FOR 920B STORES

A28

LATEST MI INCORPORATED; MI. ~~2997~~ 2998

ISSUE No.	1
ALTN No.	1681
DATE	3-10-66
INITIALS	M.P.C.
PARTS LIST No.	

DRAWN R.F. Cole | CHECKED F. C.S.743 | APPROVED | DATE 4-11-66

MATERIAL | FINISH

© Elliott Brothers (London) Limited
THIS DRAWING IS THE PROPERTY OF ELLIOTT BROTHERS (LONDON) LIMITED AND MAY NOT BE COPIED USED OR DISCLOSED FOR ANY PURPOSE EXCEPT AS AUTHORISED IN WRITING BY ELLIOTT BROTHERS (LONDON) LIMITED

TOLERANCES
DECIMAL ±
FRACTIONAL ±
ANGULAR DIMENSIONS ±
UNLESS OTHERWISE STATED

TITLE ~~XG5~~-128 SELECTION SYSTEM FOR 920B STORES X65

ELLIOTT BROTHERS (LONDON) LTD

SCALE —

DRAWING No. 322D7938